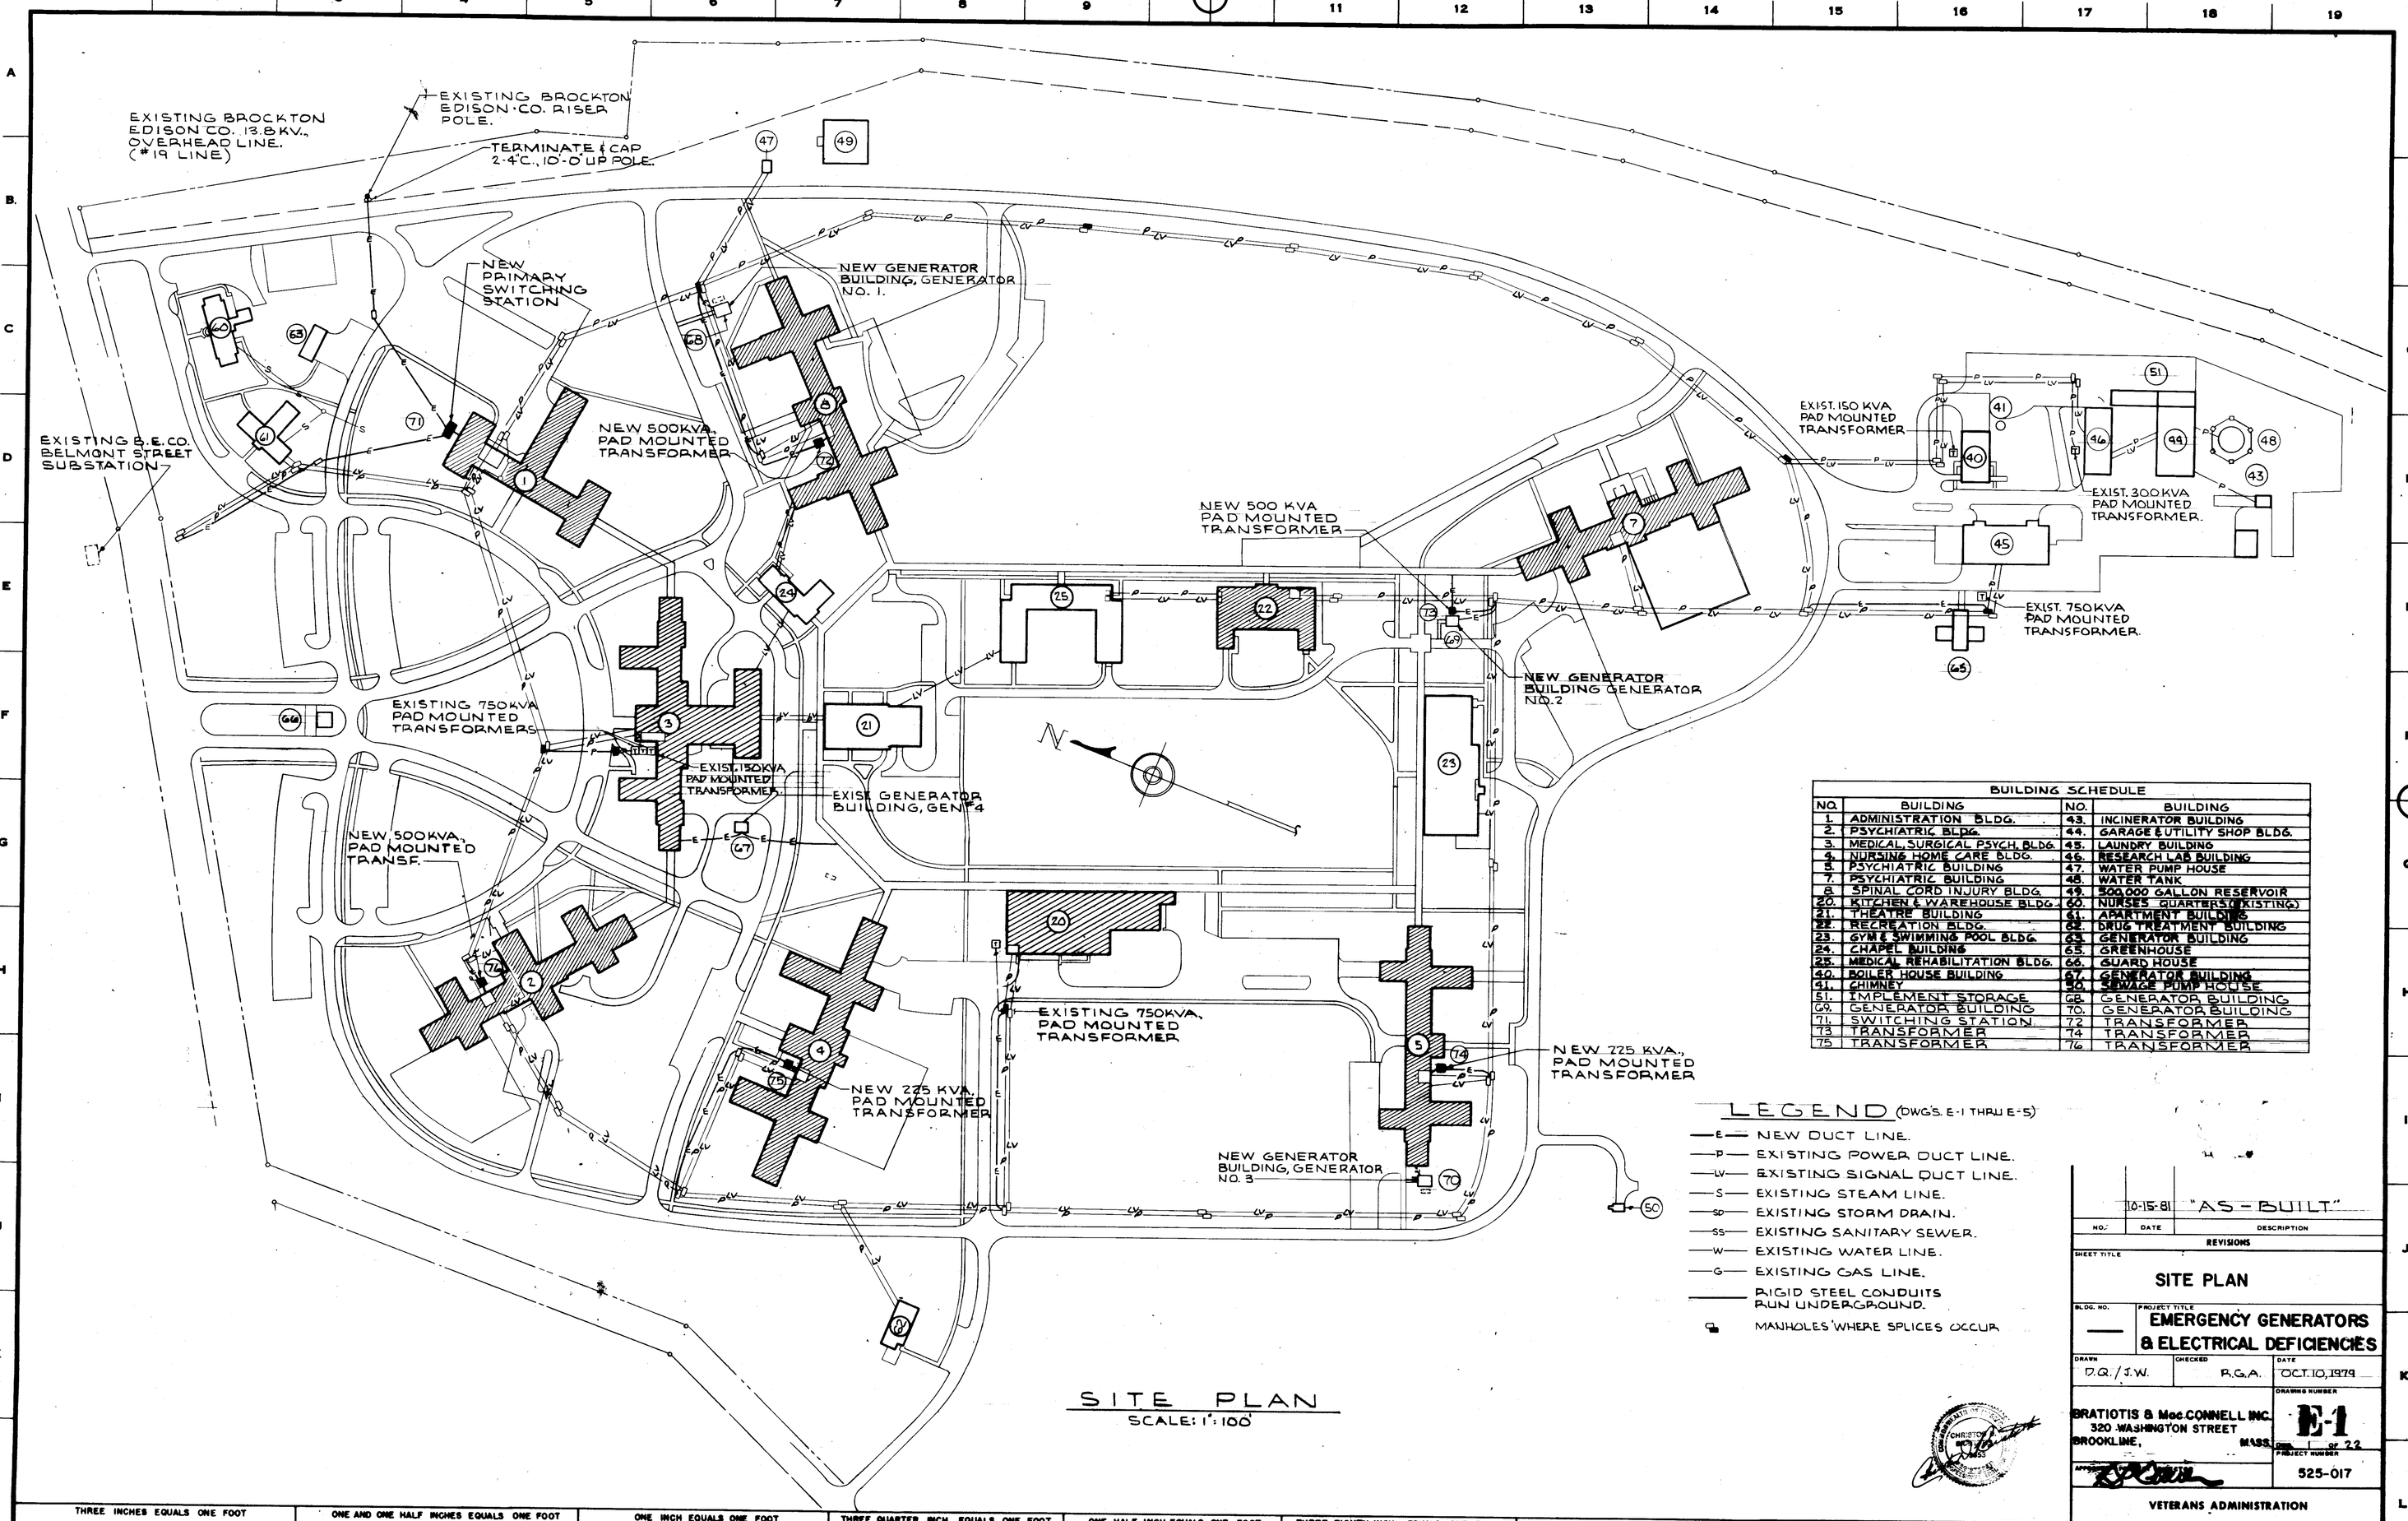

BUILDING SCHEDULE			
NO.	BUILDING	NO.	BUILDING
1.	ADMINISTRATION BLDG.	43.	INCINERATOR BUILDING
2.	PSYCHIATRIC BLDG.	44.	GARAGE & UTILITY SHOP BLDG.
3.	MEDICAL, SURGICAL PSYCH. BLDG.	45.	LAUNDRY BUILDING
4.	NURSING HOME CARE BLDG.	46.	RESEARCH LAB BUILDING
5.	PSYCHIATRIC BUILDING	47.	WATER PUMP HOUSE
7.	PSYCHIATRIC BUILDING	48.	WATER TANK
8.	SPINAL CORD INJURY BLDG.	49.	500,000 GALLON RESERVOIR
20.	KITCHEN & WAREHOUSE BLDG.	60.	NURSES QUARTERS (EXISTING)
21.	THEATRE BUILDING	61.	APARTMENT BUILDING
22.	RECREATION BLDG.	62.	DRUG TREATMENT BUILDING
23.	GYM & SWIMMING POOL BLDG.	63.	GENERATOR BUILDING
24.	CHAPEL BUILDING	65.	GREENHOUSE
25.	MEDICAL REHABILITATION BLDG.	66.	GUARD HOUSE
40.	BOILER HOUSE BUILDING	67.	GENERATOR BUILDING
41.	CHIMNEY	80.	SEWAGE PUMP HOUSE
51.	IMPLEMENT STORAGE	68.	GENERATOR BUILDING
69.	GENERATOR BUILDING	70.	GENERATOR BUILDING
71.	SWITCHING STATION	72.	TRANSFORMER
73.	TRANSFORMER	74.	TRANSFORMER
75.	TRANSFORMER	76.	TRANSFORMER

LEGEND (DWG'S. E-1 THRU E-5)

- —E— NEW DUCT LINE.
- —P— EXISTING POWER DUCT LINE.
- —LV— EXISTING SIGNAL DUCT LINE.
- —S— EXISTING STEAM LINE.
- —SD— EXISTING STORM DRAIN.
- —SS— EXISTING SANITARY SEWER.
- —W— EXISTING WATER LINE.
- —G— EXISTING GAS LINE.
- RIGID STEEL CONDUITS RUN UNDERGROUND.
- MANHOLES WHERE SPLICES OCCUR

SITE PLAN

SCALE: 1" = 100'

NO.	DATE	DESCRIPTION
	10-15-81	"AS-BUILT"

REVISIONS

SHEET TITLE: SITE PLAN

BLDG. NO.: —

PROJECT TITLE: EMERGENCY GENERATORS & ELECTRICAL DEFICIENCIES

DRAWN: D.Q. / J.W. | CHECKED: R.G.A. | DATE: OCT. 10, 1979

DRAWING NUMBER: E-1 SHEET 1 OF 22

PROJECT NUMBER: 525-017

BRATIOTIS & MacCONNELL INC.
320 WASHINGTON STREET
BROOKLINE, MASS.

VETERANS ADMINISTRATION

LOCATION: V.A.M.C. BROCKTON, MASSACHUSETTS

THREE INCHES EQUALS ONE FOOT | ONE AND ONE HALF INCHES EQUALS ONE FOOT | ONE INCH EQUALS ONE FOOT | THREE QUARTER INCH EQUALS ONE FOOT | ONE HALF INCH EQUALS ONE FOOT | THREE EIGHTH INCH EQUALS ONE FOOT | ONE QUARTER INCH EQUALS ONE FOOT | ONE EIGHTH INCH EQUALS ONE FOOT