BLDG. #61

FLOOR PLANS

DRAWING # 61-E1

JAN. 1951

SHEET # 1 of 1

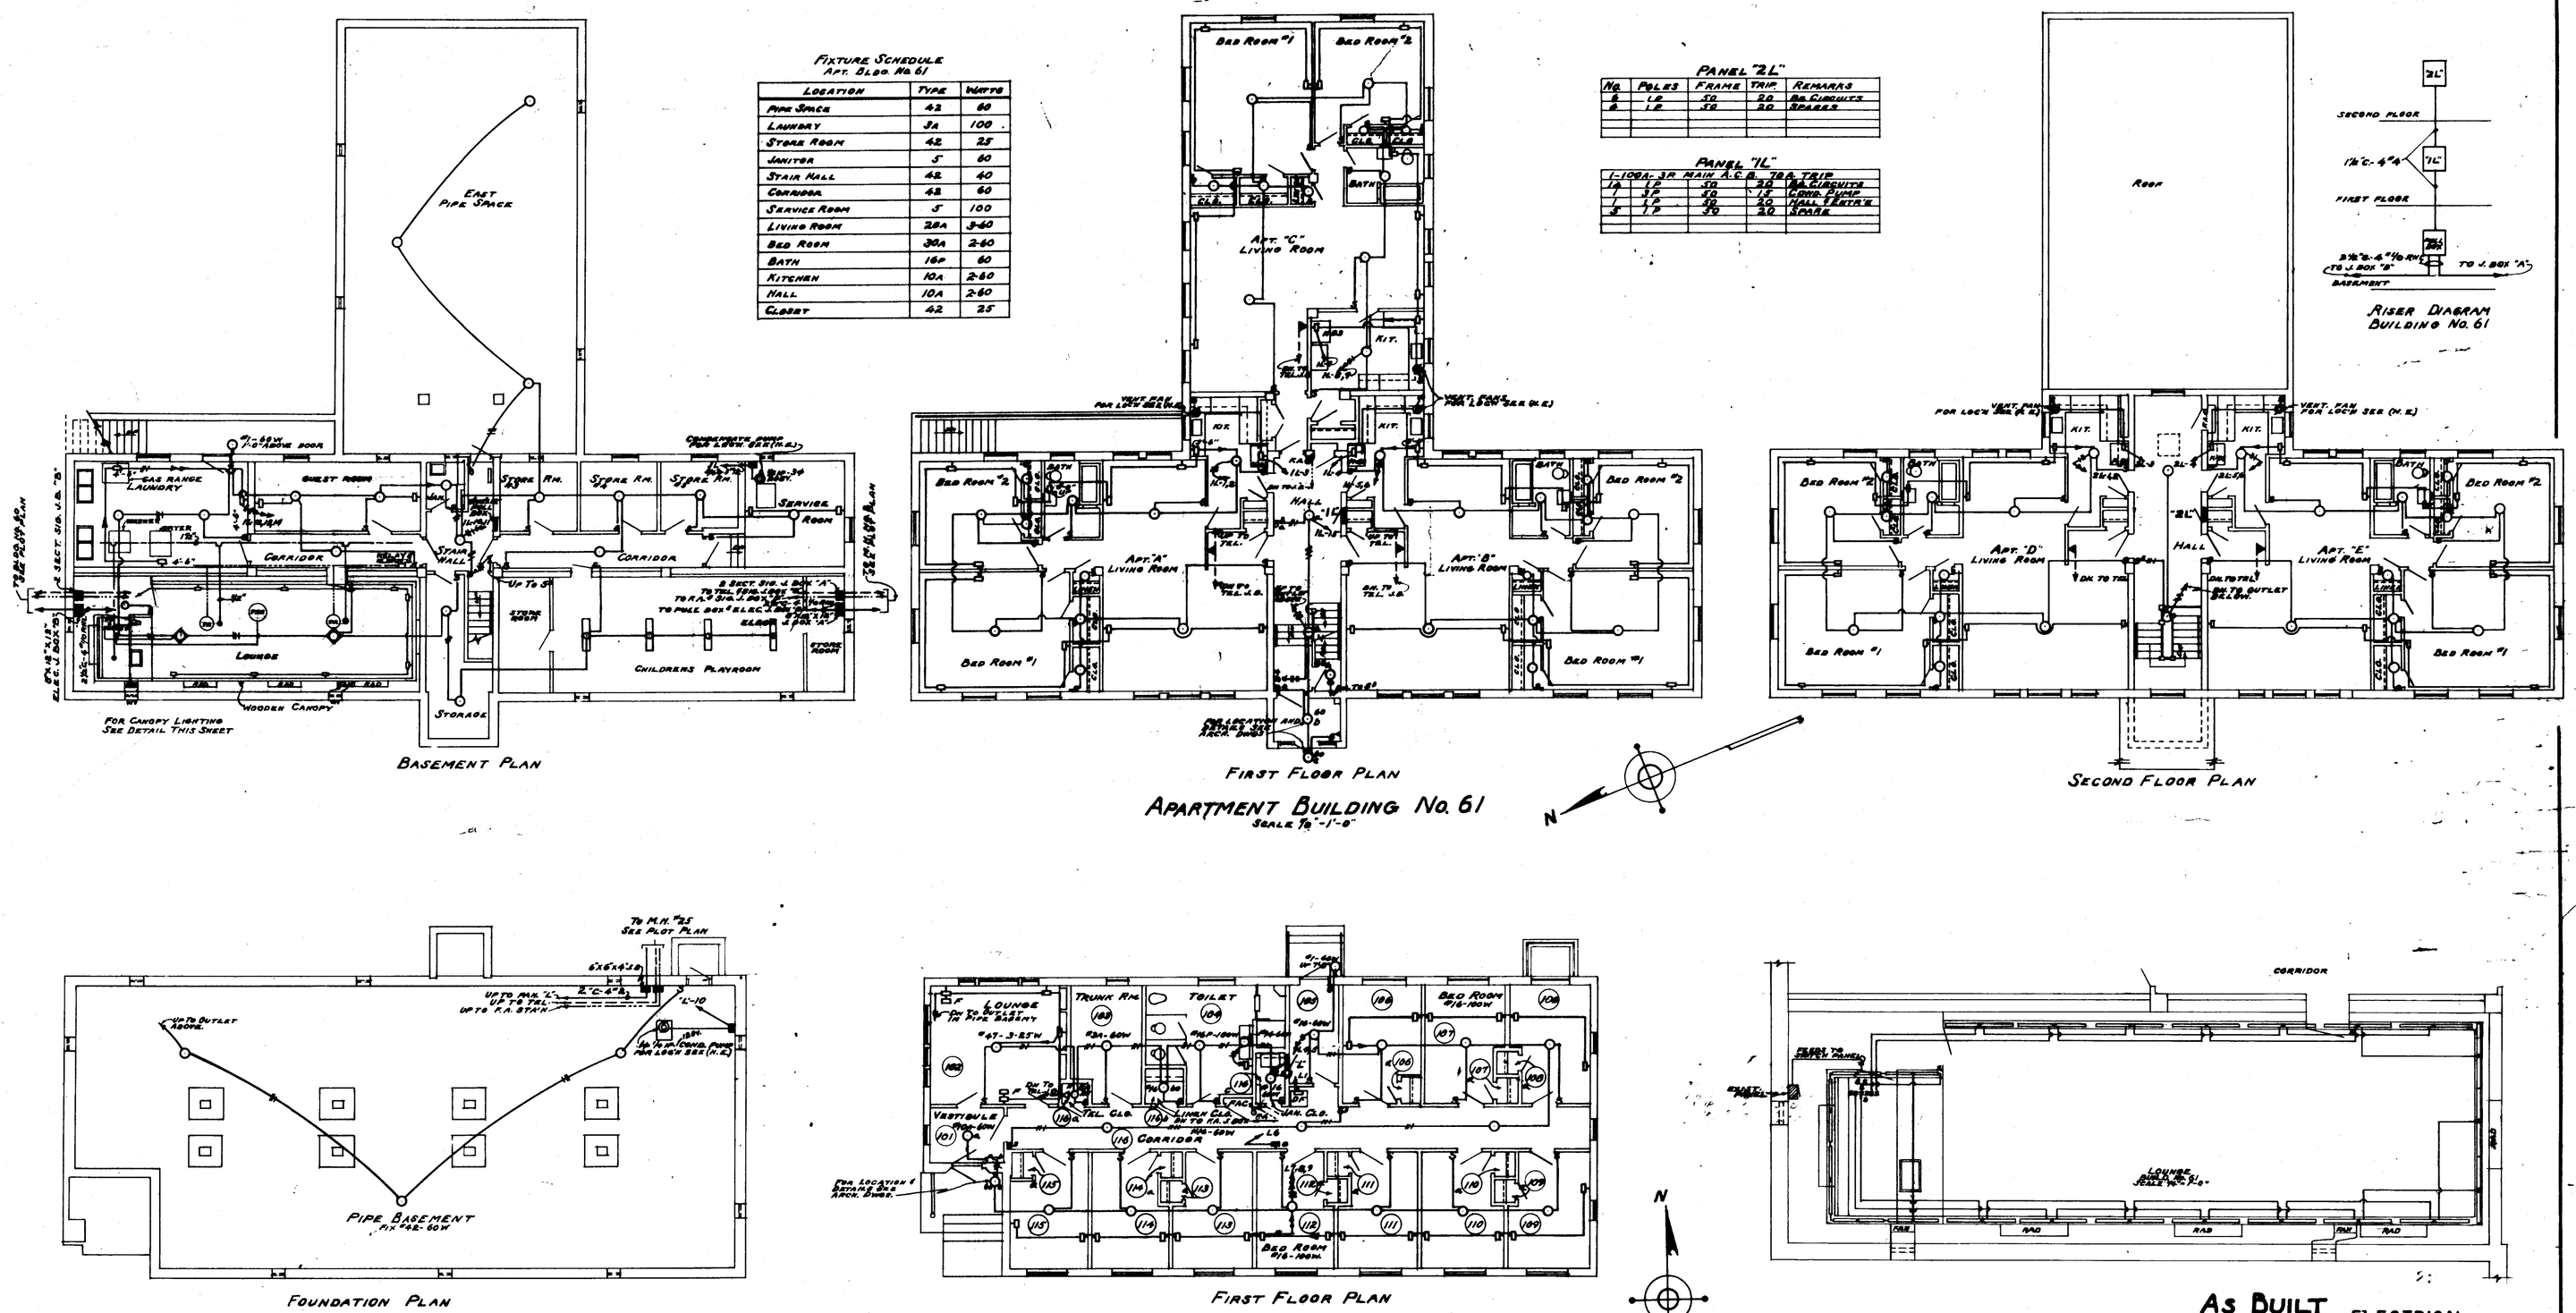

FIXTURE SCHEDULE
APT. BLDG. No. 61

LOCATION	TYPE	WATTS
PIPE SPACE	42	60
LAUNDRY	3A	100
STORE ROOM	42	25
JANITOR	S	60
STAIR HALL	42	40
CORRIDOR	42	60
SERVICE ROOM	S	100
LIVING ROOM	28A	3-60
BED ROOM	30A	2-60
BATH	16P	60
KITCHEN	10A	2-60
HALL	10A	2-60
CLOSET	42	25

PANEL "2L"

No.	POLES	FRAME	TRIP	REMARKS
8	1P	50	20	8 CIRCUITS
8	1P	50	20	SPARES

PANEL "1L"

1-100A. 3P MAIN A.C.B.		70 A. TRIP	
1A	1P	50	30	8 CIRCUITS
1	3P	50	15	LOND. FUSE
1	1P	50	20	HALL "ENTR'E
5	1P	50	20	SPARE

PANEL "L"
3φ 4W 5/16 120/208V MAINS
MAIN A.C.B. 60A. FRAME, 50A. TRIP
9-1P-20A. A.C.B.
1-1P-20A. A.C.B.
4-1P-20A. A.C.B. SPARE

VETERANS ADMINISTRATION
WASHINGTON, D. C.

ASSISTANT ADMINISTRATOR

DIRECTOR, TECHNICAL SERVICE

AS BUILT 9/26/55 ELECTRICAL

FLOOR PLANS
APARTMENT BUILDING NO. 61
ATTENDANTS QUARTERS NO. 62

BROCKTON, MASS.

M.B.W.		61-E1
M.B.W.		
4/24/51		
M. C. Stephens		1"=40'50

2-5-1-1050

RETURN TRACINGS TO PLAN FILES

RETURN TRACINGS TO PLAN FILES

FILE COPY NO. 3

U.S. GOVERNMENT PRINTING OFFICE : 1951 O - 3-4052