


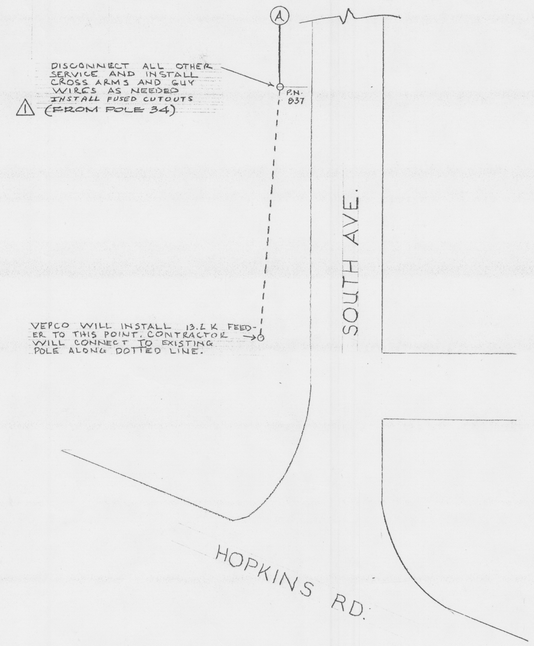


GENERAL LEGEND

- EXISTING LINES, POLES, AND TRANSFORMERS
- NEW LINES, POLES, AND TRANSFORMERS
- OWR WEATHER HEADS EXISTING
- NEW HIGH VOLTAGE WIRE
- DDE DOUBLE DEAD END HIGH VOLTAGE LINES

NOTES:

1- THE FOLLOWING WILL BE FURNISHED BY VETERANS ADM. FOR INSTALLATION BY CONTRACTOR:

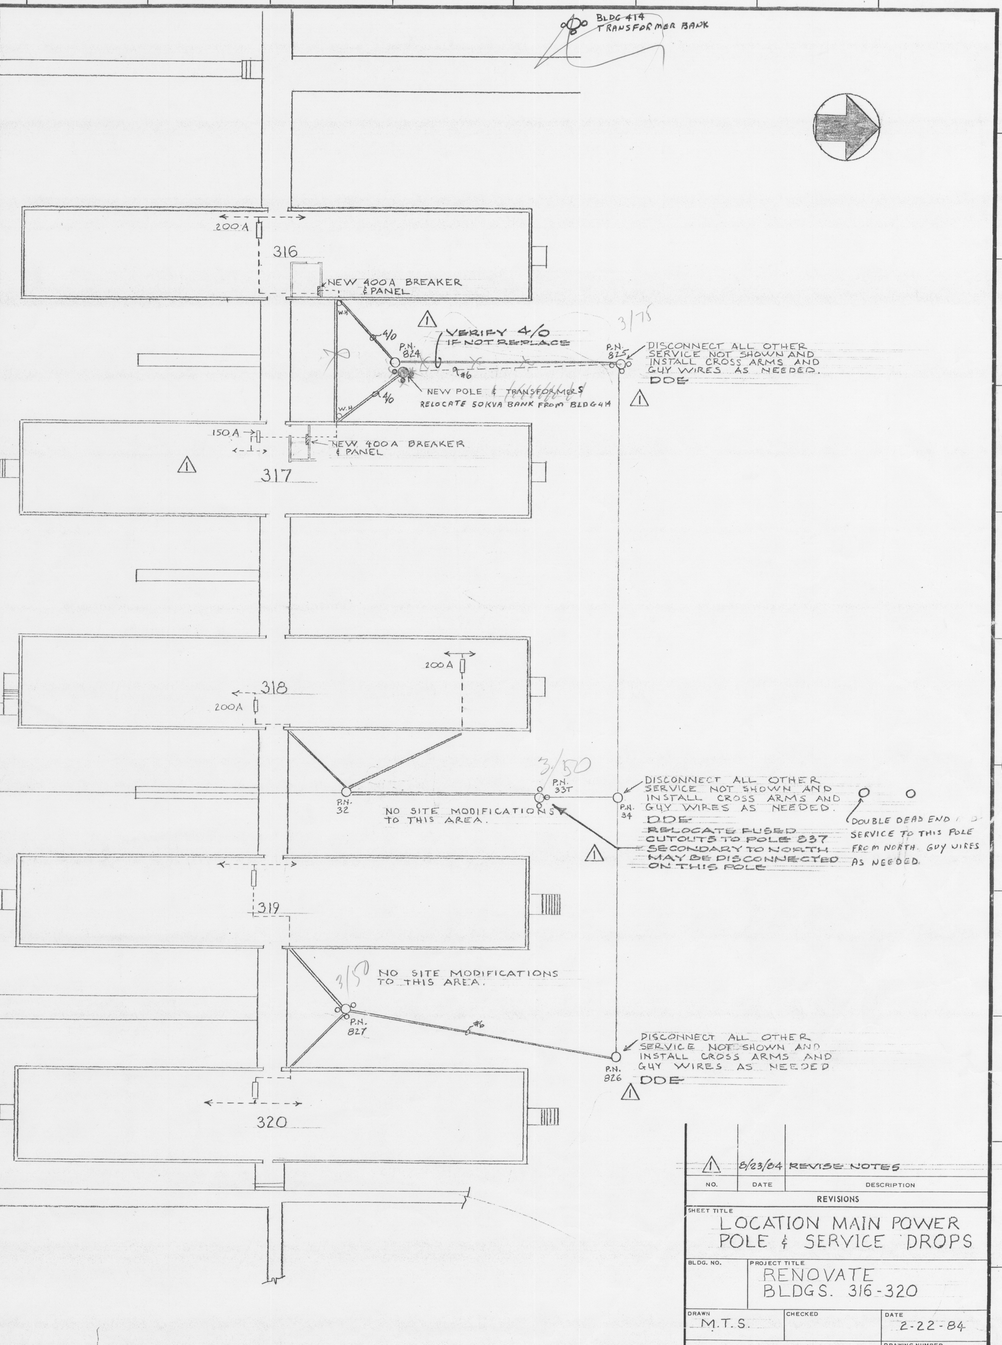TRANSFORMERS - REMOVE FROM POLE AT BLDG. 414.
CROSS ARMS - REMOVE FROM POLES (CONTACT ENGINEERING AT TIME OF NEED)
LINE SWITCHES - REMOVE FROM POLE #34
FUSED CUTOUTS

2- THE CONTRACTOR TO PROVIDE ALL LABOR AND EQUIPMENT REQUIRED TO INSTALL VA FURNISHED EQUIP. AND IN ADDITION WILL FURNISH THE FOLLOWING:

TRANSFORMER MOUNTING HARDWARE
WIRE
CONDUIT
GUY WIRES
POLES
ANCHORS & GROUND RODS

3- SEE AS BUILT DRAWINGS FOR EXISTING CONDITIONS.

SCALE: 1"=20'

| NO. | DATE | DESCRIPTION |
|---|---|---|
| 1 | 8/23/84 | REVISE NOTES |

REVISIONS

SHEET TITLE: LOCATION MAIN POWER POLE & SERVICE DROPS

BLDG. NO.

PROJECT TITLE: RENOVATE BLDGS. 316-320

DRAWN: M.T.S.

CHECKED:

DATE: 2-22-84

APPROVED: DIVISION CHIEF

DRAWING NUMBER: E-2

DWG. 2 OF 2

PROJECT NUMBER: 651-84-101

APPROVED: SERVICE DIRECTOR

VETERANS ADMINISTRATION

LOCATION: RICHMOND, VA.

THREE INCHES EQUALS ONE FOOT | ONE AND ONE HALF INCHES EQUALS ONE FOOT | ONE INCH EQUALS ONE FOOT | THREE QUARTER INCH EQUALS ONE FOOT | ONE HALF INCH EQUALS ONE FOOT | THREE EIGHTH INCH EQUALS ONE FOOT | ONE QUARTER INCH EQUALS ONE FOOT | ONE EIGHTH INCH EQUALS ONE FOOT

VA FORM 08-6231, FEB 1973

☆ U. S. GOVERNMENT PRINTING OFFICE: 1978 O - 233-573